


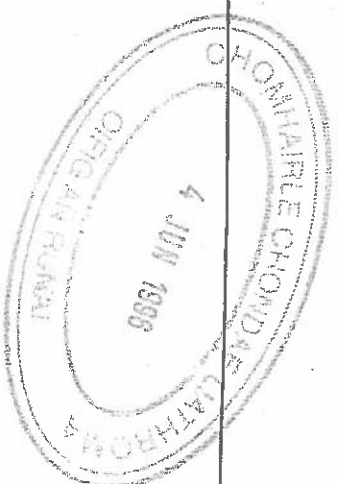

RETENTION OF B&B PROPERTY
AT
AUGHAMORE, DROMOD, CO. LEITRIM.
FOR

MR. DEREK ROWLEY.


PLANNING SECTION
LEITRIM COUNTY COUNCIL

ED/25/010
18/03/2025


REF P.

May 1996.

MIDLAND DESIGN SERVICES LTD.

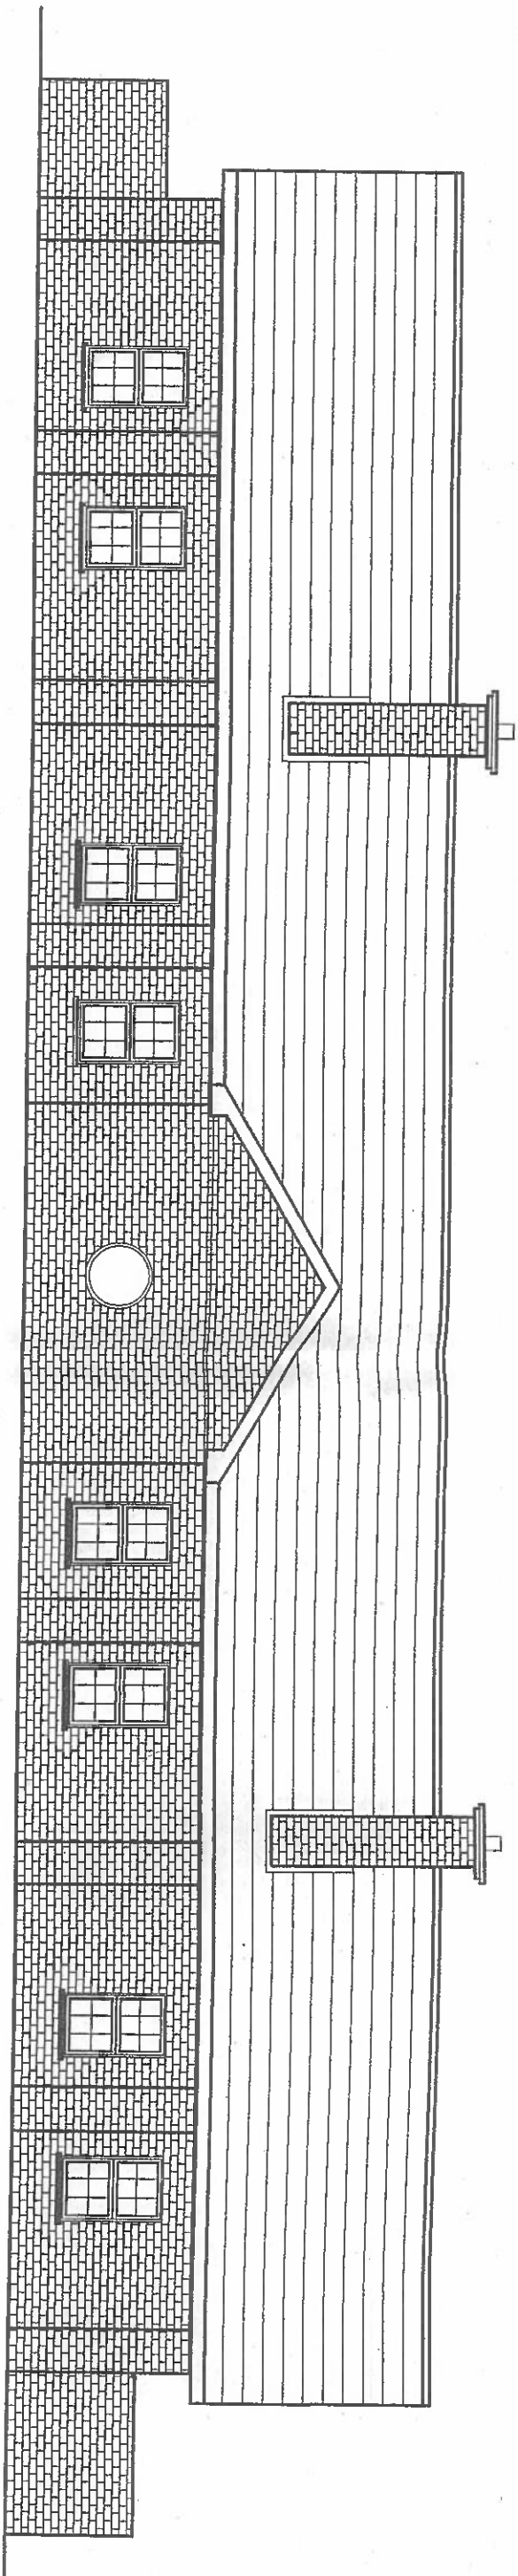


FRONT ELEVATION

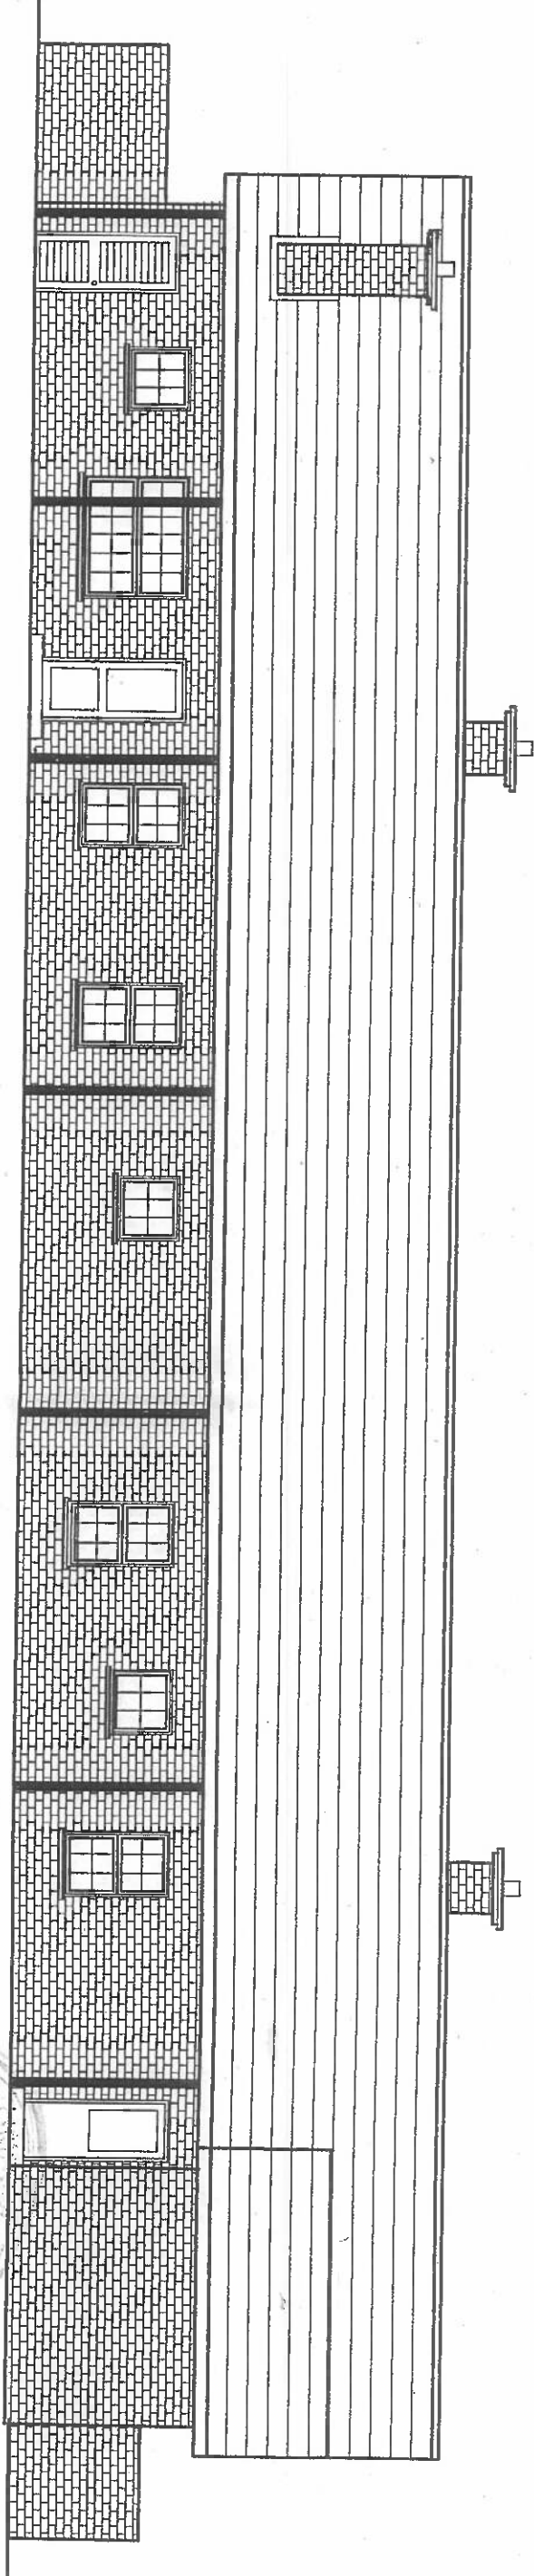


REAR ELEVATION

Job No. C960514-	Dwg. No. 02	Rev.	Drawn By: D.H.	Scale: 1:100	Date: MAY '96
Drawing Title: ELEVATIONS			Job Title: RETENTION OF B&B PROPERTY AND GARAGE AS CONSTRUCTED AT AUGHAMORE, DROMOD, CO. LEITRIM. FOR DEREK ROWLEY.		

MIDLAND DESIGN SERVICES
CONSULTANT ENGINEERS, QUANTITY SURVEYORS
BRIDGE ST. • CK.-ON-SHANNON • CO. LEITRIM
Tel: 078-21111 Fax: 078-20000

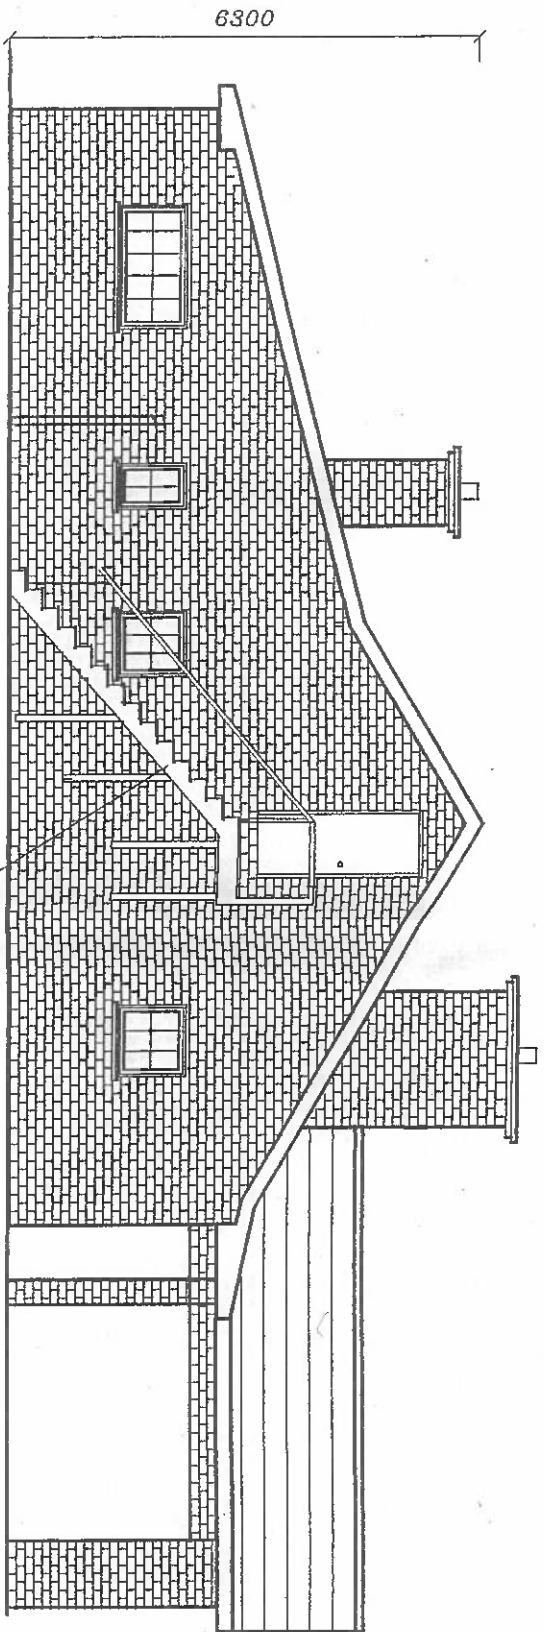

NORTH FACING ELEVATION

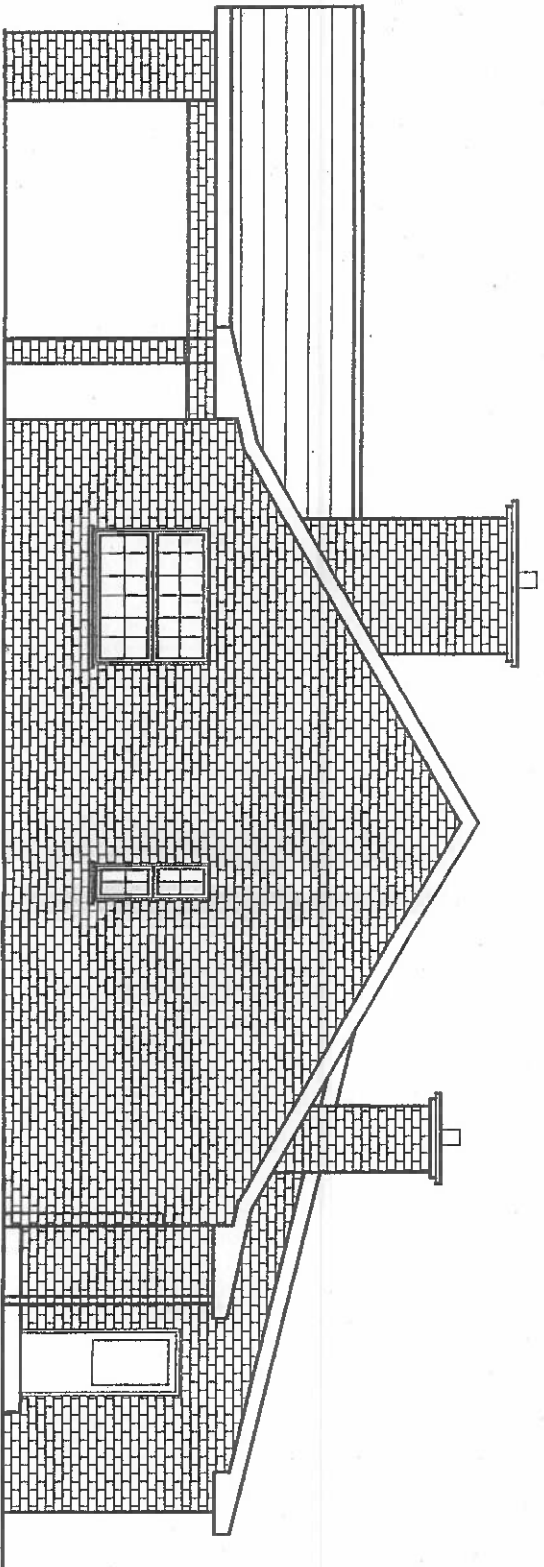

SOUTH FACING ELEVATION


NOTE:

ATTIC SPACE USED
FOR STORAGE ONLY.




Job No. C960514	Dwg. No. 03	Rev.	Drawn By: D.H.	Scale: 1:100	Date: MAY '96	Revision	Description	Date	By
Drawing Title: SIDE ELEVATIONS						Job Title: RETENTION OF B&B PROPERTY AND GARAGE AS CONSTRUCTED AT AUGHAMORE, DROMOD, CO. LEITRIM FOR MR. DEREK ROWLEY.			


MIDLAND DESIGN SERVICES
CONSULTANT ENGINEERS, QUANTITY SURVEYORS
BRIDGE ST. • CK.-ON-SHANNON • CO. LEITRIM
Tel: 078-21111 Fax: 078-20000

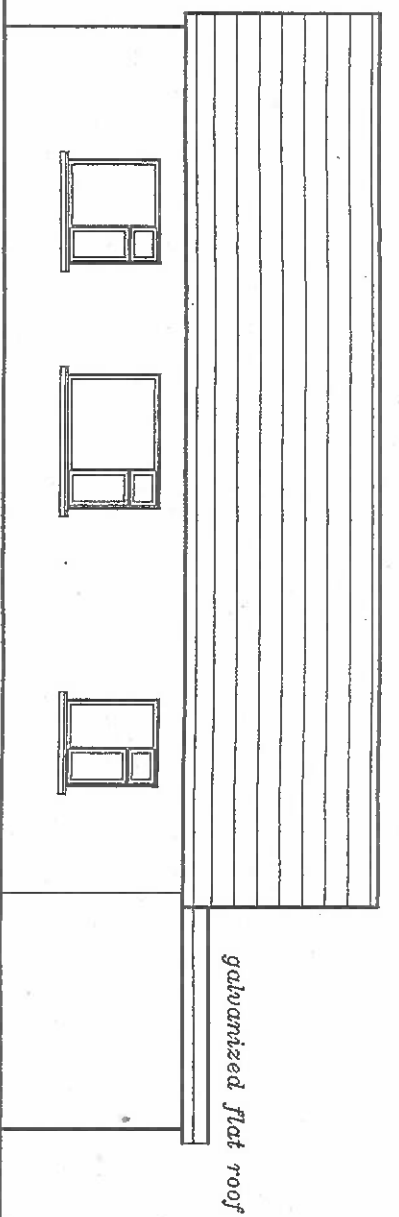


REAR ELEVATION

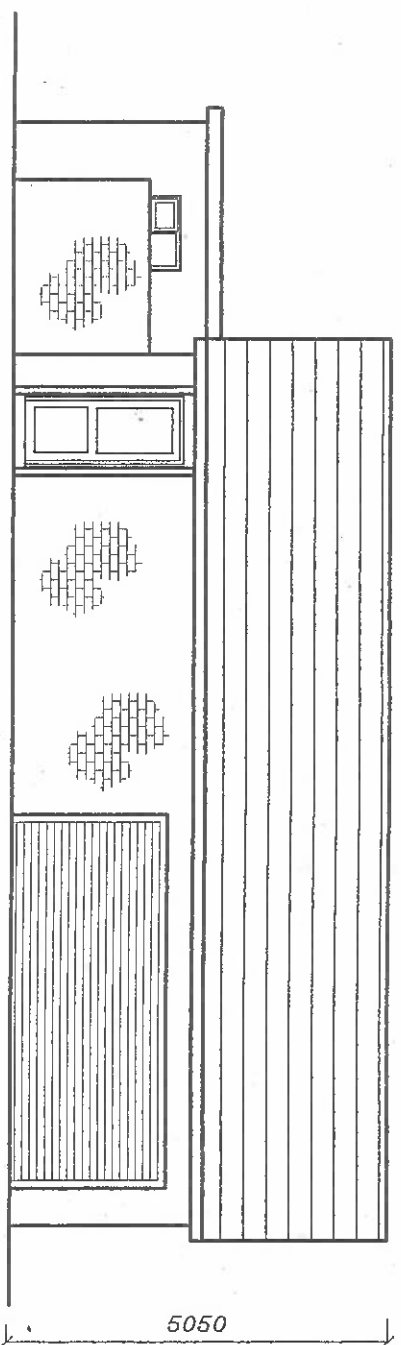


FRONT ELEVATION

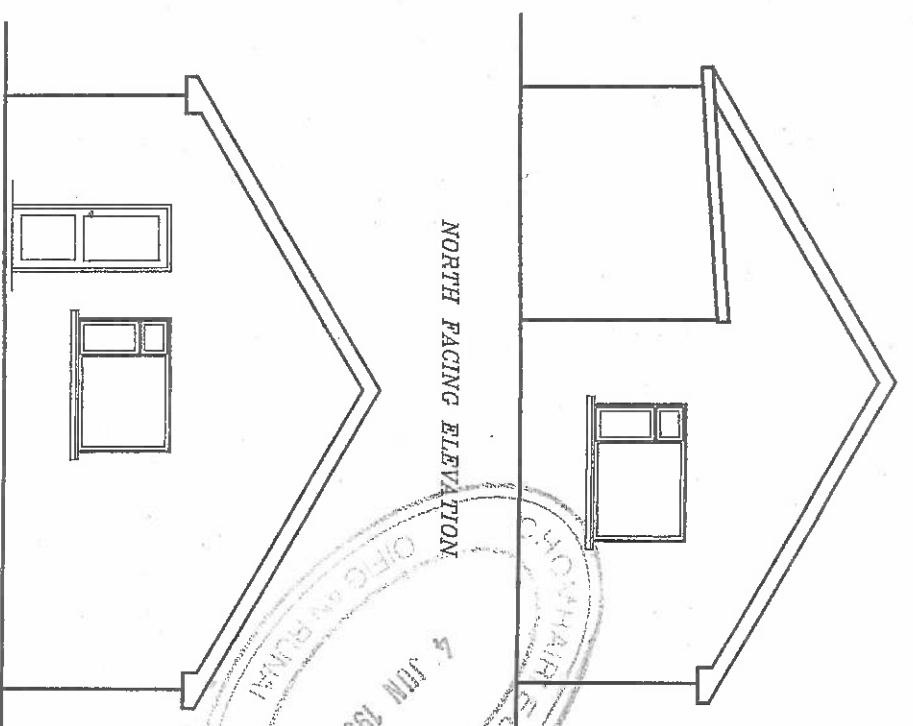


NORTH FACING ELEVATION

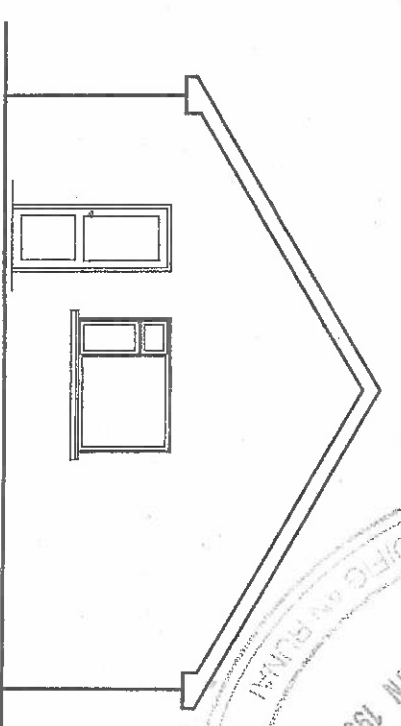

SOUTH FACING ELEVATION

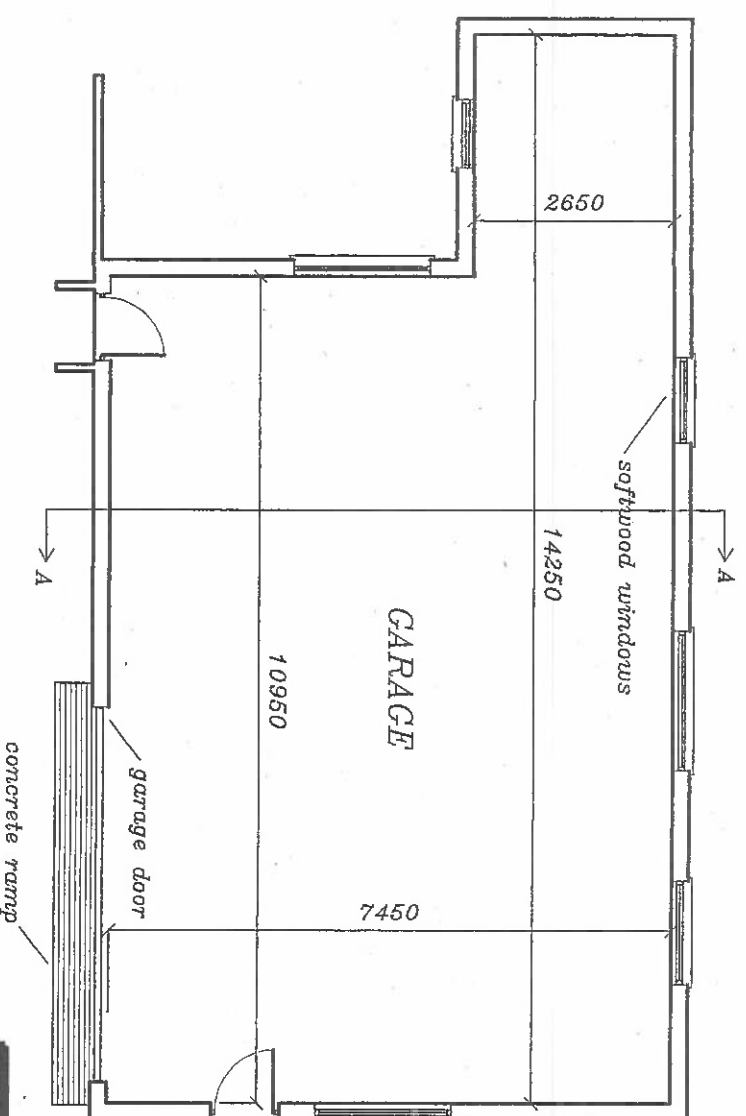




FLOOR PLAN

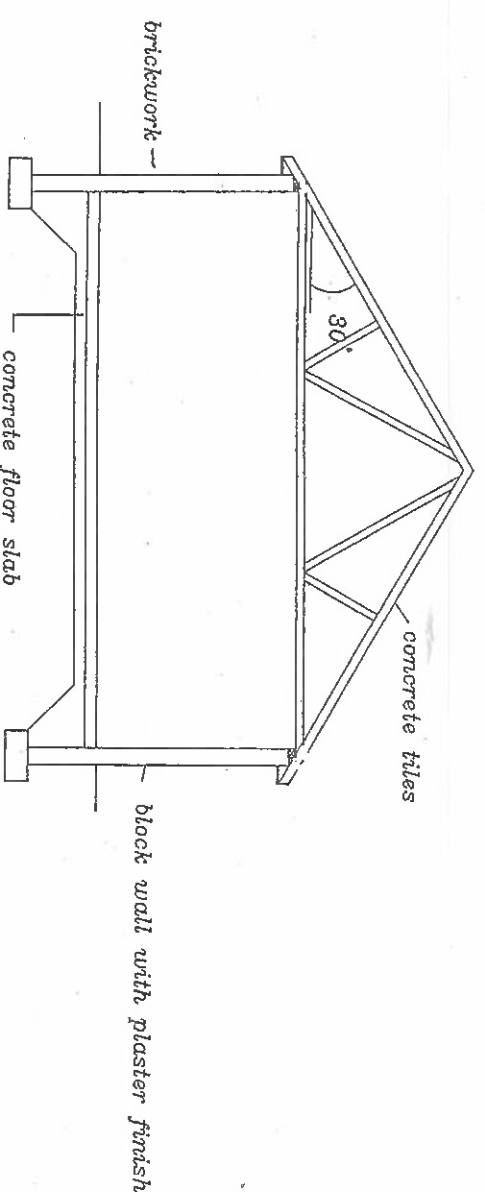

SECTION A.A

Job No. C960514	Drg. No. 05	Rev.	Drawn By: D.H.	Scale: 1:100	Date: MAY '96
Drawing Title: GARAGE PLANS & ELEVATIONS			Job Title: RETENTION OF B&B PROPERTY AND GARAGE AS CONSTRUCTED AT AUGHAMORE, DROMOD, CO. LEITRIM. FOR MR. DEREK ROWLEY.		

MIDLAND DESIGN SERVICES
CONSULTANT ENGINEERS, QUANTITY SURVEYORS
BRIDGE ST. • CK.-ON-SHANNON • CO. LEITRIM
Tel: 078-211111 Fax: 078-20000

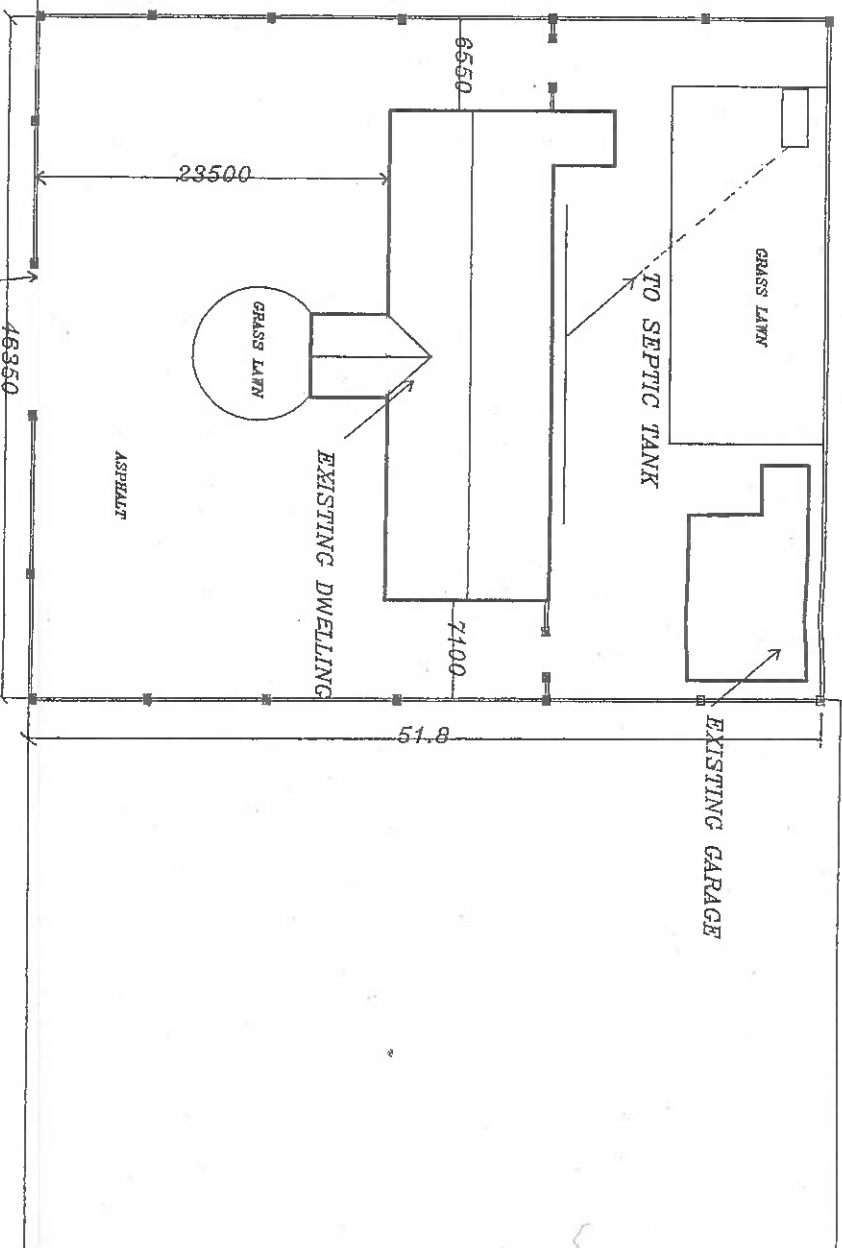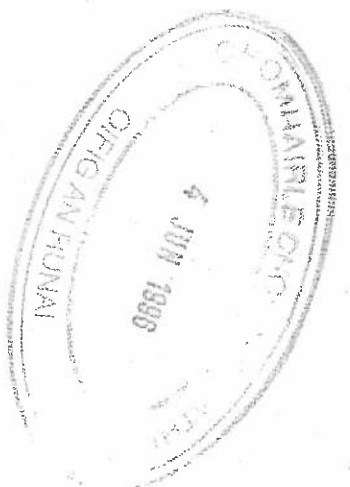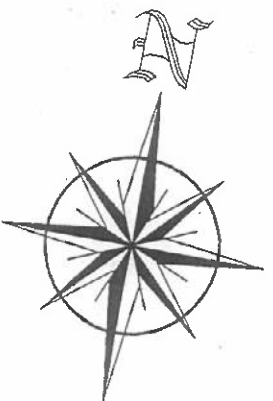

← ROAD TO SILGO

MAIN ROAD

TO DUBLIN →

Site Notice

Job No. C960514	Dwg. No. 06	Rev.	Drawn By: D.H.	Scale: 1:500	Date: MAY '96
Drawing Title: SITE LAYOUT MAP			Job Title: RETENTION OF B&B PROPERTY AND GARAGE AS CONSTRUCTED AT AUGHAMORE, DROMOD, CO. LEITRIM FOR MR. DEREK ROWLEY.		
Revision		Description	Date	By	
MIDLAND DESIGN SERVICES CONSULTANT ENGINEERS, QUANTITY SURVEYORS BRIDGE ST. • CK.-ON-SHANNON • CO. LEITRIM Tel: 078-21111 Fax: 078-20000					